



# JAMES RIVER CORPORATION BERLIN, NEW HAMPSHIRE MT. CARBERRY SECURE LANDFILL STAGE 3

SHT NO.	TITLE	DWG NO
1	COVER SHEET	
2	SYMBOLS, ABBREVIATIONS & MATERIAL SPECIFICATIONS	C-100
3	SITE LOCATION PLAN	C-101
4	PHASE I DEVELOPMENT PLAN	C-102
5	BASE GRADING PLAN	C-103
6	UNDERDRAIN PLAN	C-104
7	LEAK DETECTION SYSTEM	C-105
8	LEACHATE COLLECTION SYSTEM	C-106
9	FINAL GRADING PLAN	C-107
10	LEACHATE COLLECTION DETAILS	C-300
11	DETAILS - ACCESS ROAD & DRAINAGE STRUCTURES	C-301

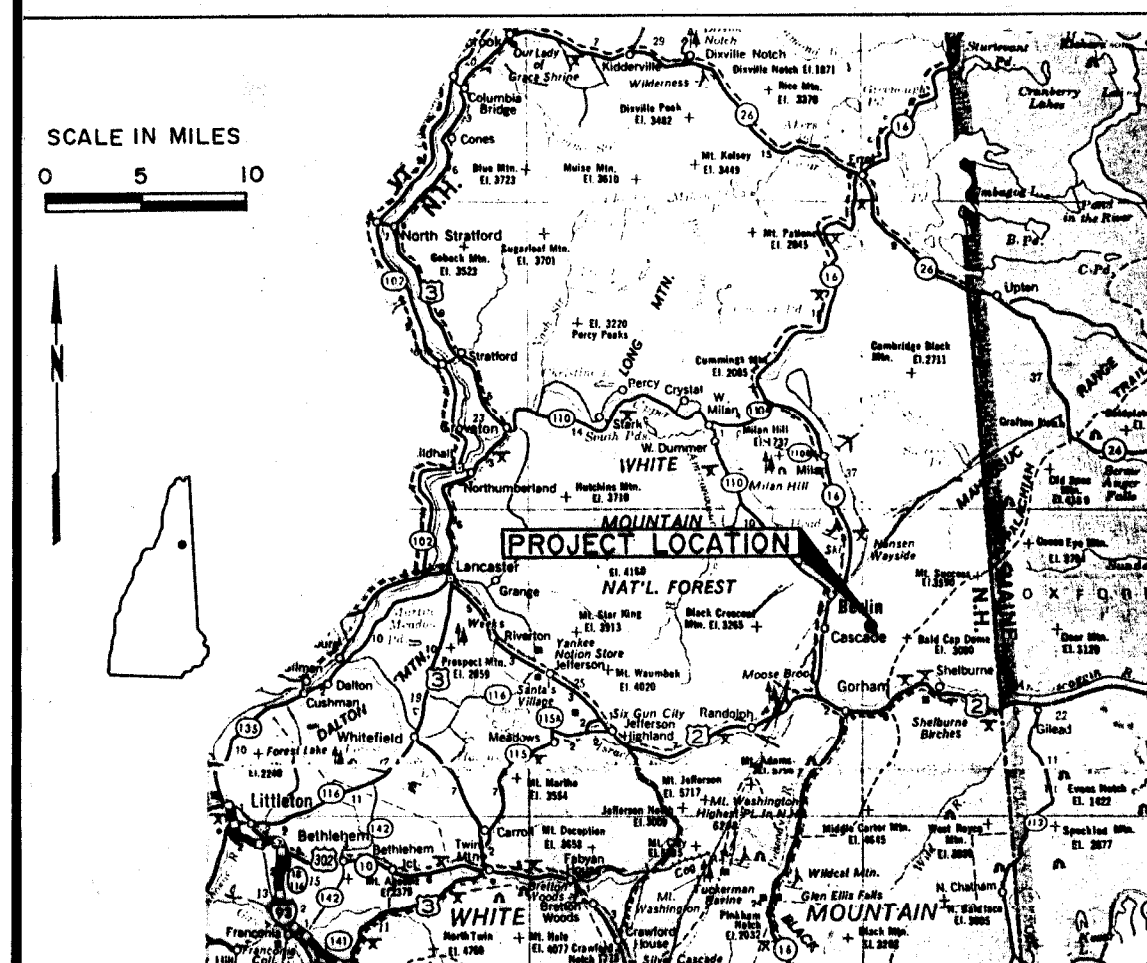

SEVEE & MAHER ENGINEERS, INC.  
CUMBERLAND, MAINE  
1993

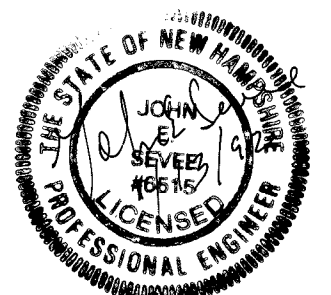

RECORD DRAWING