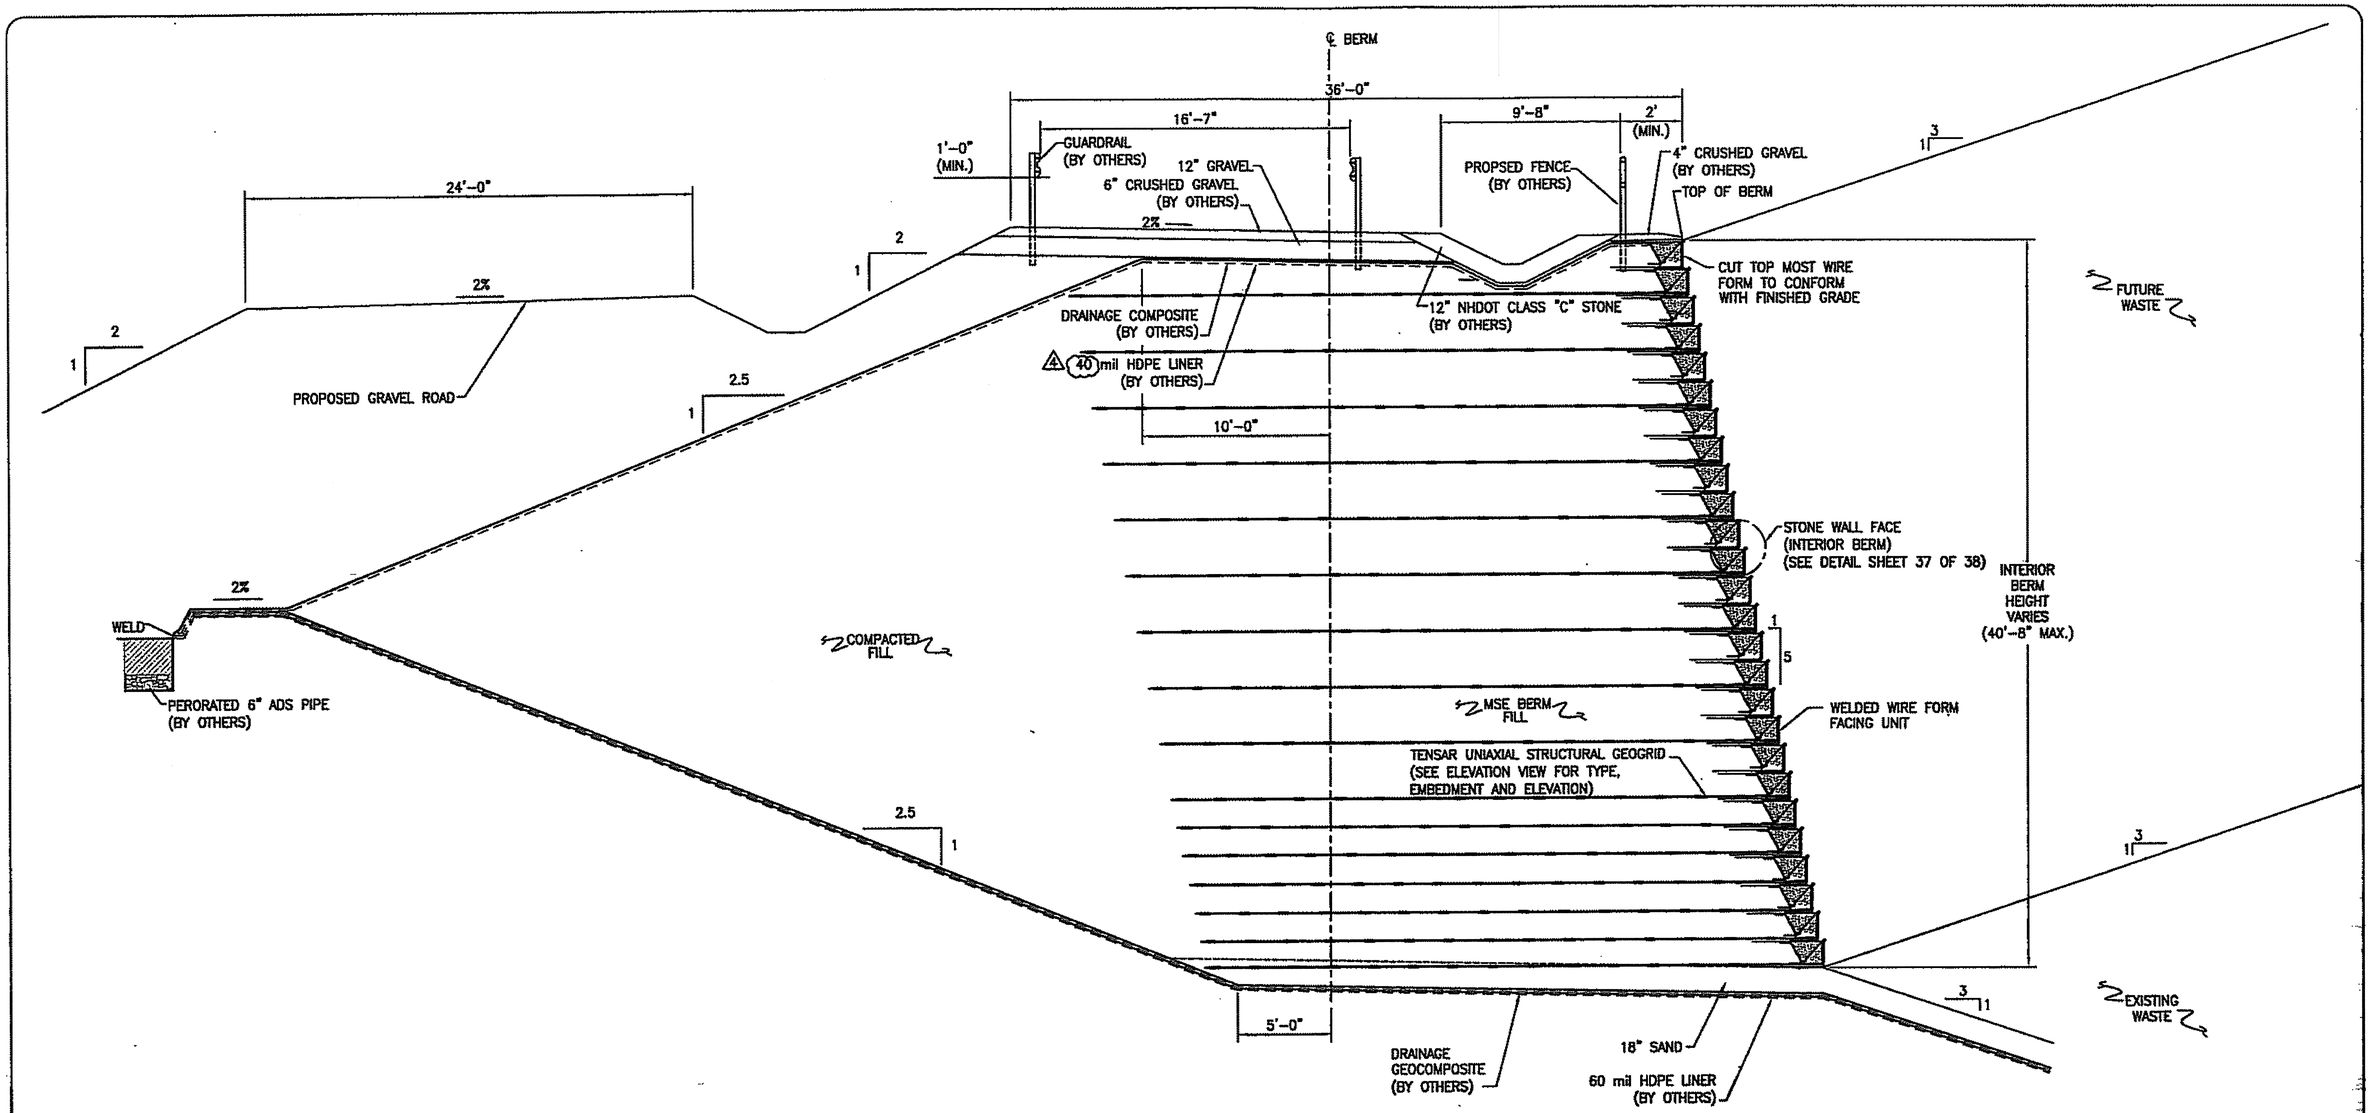

TYPICAL CROSS-SECTION
(STA. 13+00 TO STA. 28+00 - WESTERN BERM)

SCALE
4 2 0 4 8 FEET

STATE OF NEW HAMPSHIRE
BRENDAN SHEPPARD
No. 11790
LICENSED
PROFESSIONAL ENGINEER
2/14/08

THIS DESIGN IS BASED UPON SPECIFIC PROPERTIES OF TENSAR PRODUCTS (GEOGRIDS, DRAINAGE COMPOSITES AND EROSION MEDIA), WHICH ARE PROPRIETARY TO THE TENSAR CORPORATION 1210 CITIZENS PARKWAY, MORROW, GA, 30260. ANY SUBSTITUTION OF THE SPECIFIED PRODUCTS WILL INVALIDATE THIS DESIGN. THIS DRAWING IS BEING FURNISHED FOR USE ON THIS SPECIFIC PROJECT ONLY. ANY PARTY ACCEPTING THIS DOCUMENT DOES SO IN CONFIDENCE AND AGREES THAT IT SHALL NOT BE DUPLICATED WHOLE OR IN PART, NOR DISCLOSED TO OTHERS, WITHOUT THE CONSENT OF TENSAR EARTH TECHNOLOGIES, INC.

COPYRIGHT 2007, TENSAR EARTH TECHNOLOGIES, INC.

ADD3®
CAPACITY IMPROVEMENT SYSTEMS

Tensar
Tensar Earth Technologies, Inc.
5883 Glenridge Drive, Suite 200
Atlanta, Georgia 30328
(404) 250-1290

REVISIONS \ ISSUE

3	11/27/07	NEW BERM GEOMETRY / ISSUED FOR REVIEW
4	02/13/08	REVISED PER REVIEW COMMENTS

Project Number: N06521
File Name: N06521135.DWG
Date Drawn: 11/27/07
Scale: AS SHOWN
Designed by: MS
Drawn by: JAR
Checked by:

NCES LANDFILL - STAGE IV, PHASE II

BETHLEHEM, NEW HAMPSHIRE

TYPICAL CROSS-SECTION 3

Sheet Number
35 OF 38